


FOR LEASE

3011 N. Pan Am (Interstate 35)

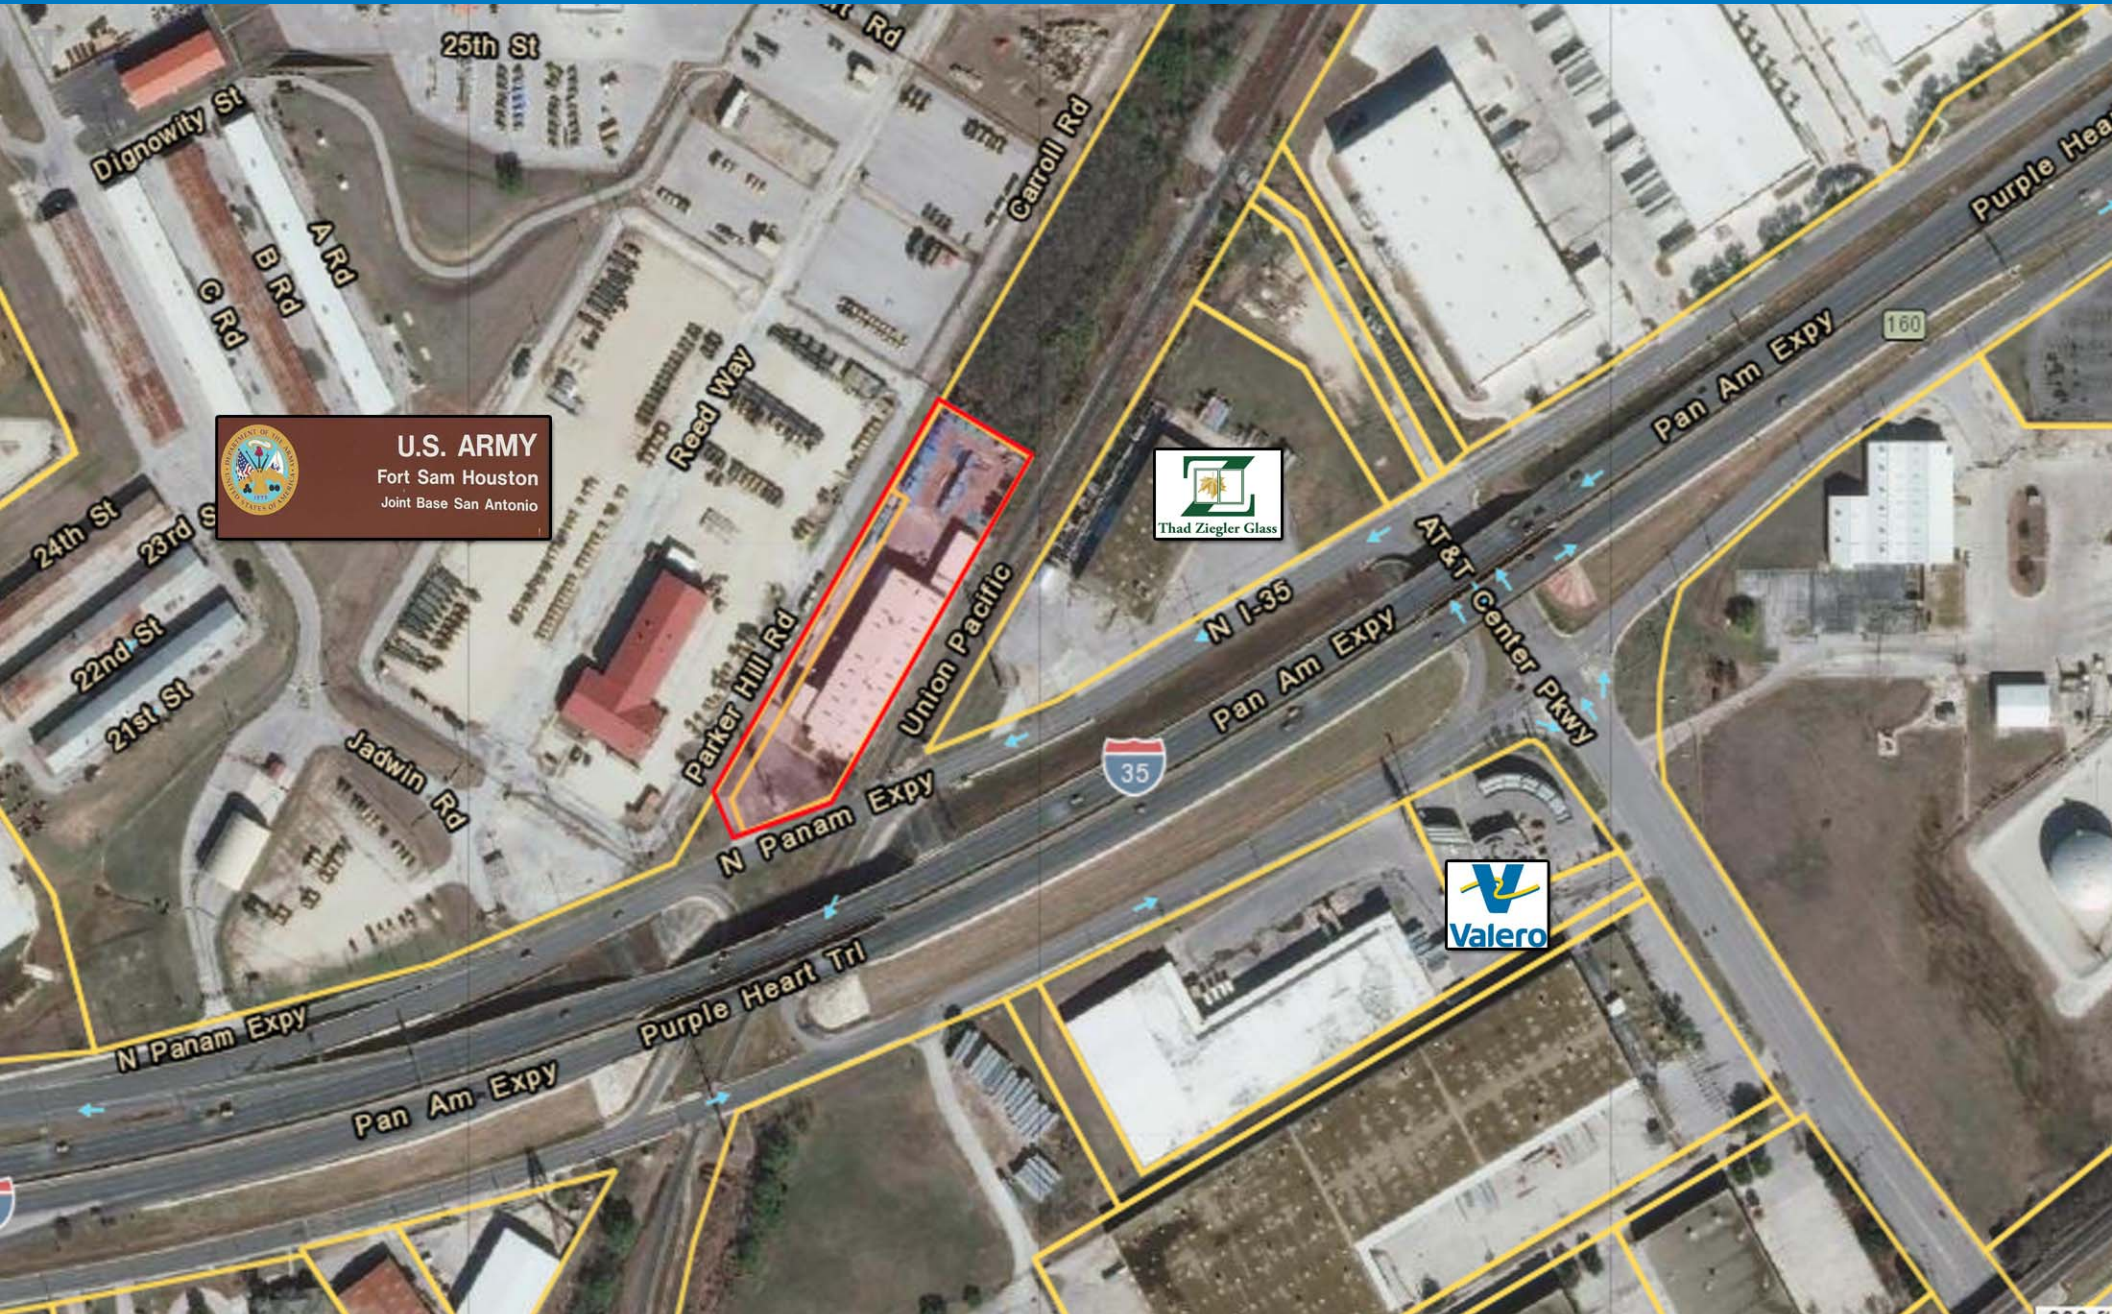

 **U.S. ARMY**
Fort Sam Houston
Joint Base San Antonio

 Thad Ziegler Glass

 Valero

The information contained herein is furnished by sources deemed reliable, but is subject to verification by purchaser or tenant. 4M Realty Company assumes no responsibility and makes no guarantees, warranties or representations as to the completeness or accuracy thereof. The offering is made subject to errors, omissions, changes of price or condition, prior sale or lease, or withdrawal without notice.


4mrealty.com

FOR LEASE
3011 N. Pan Am (Interstate 35)





29,563 SF Building
2.5 acre site - fully fenced
26,970 SF of Warehouse
2,593 SF of Office
22' Eave Height
Two (2) Dock High overhead doors
Two (2) covered loading Docks
Ramp for grade level access
Fully Sprinklered
New Roof in 2019 w/ warranty
Skylights in Warehouse
Heavy 3-Phase power
Fenced storage yard
I-1 Zoning

Lease Rate: \$17,500.00 per month + NNN

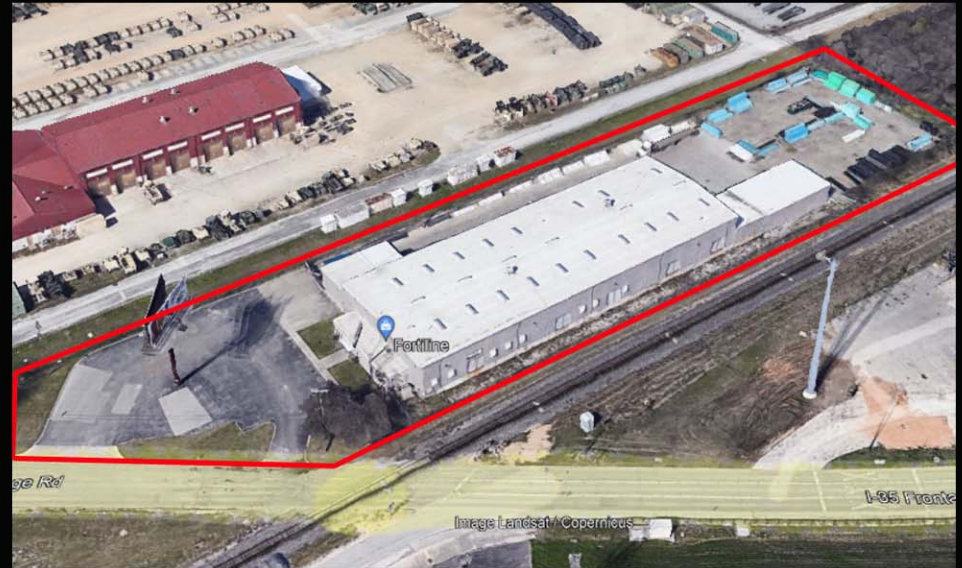


FOR LEASE

3011 N. Pan Am (Interstate 35)

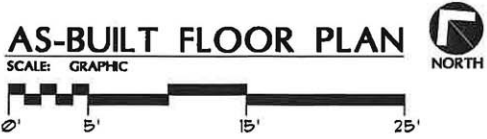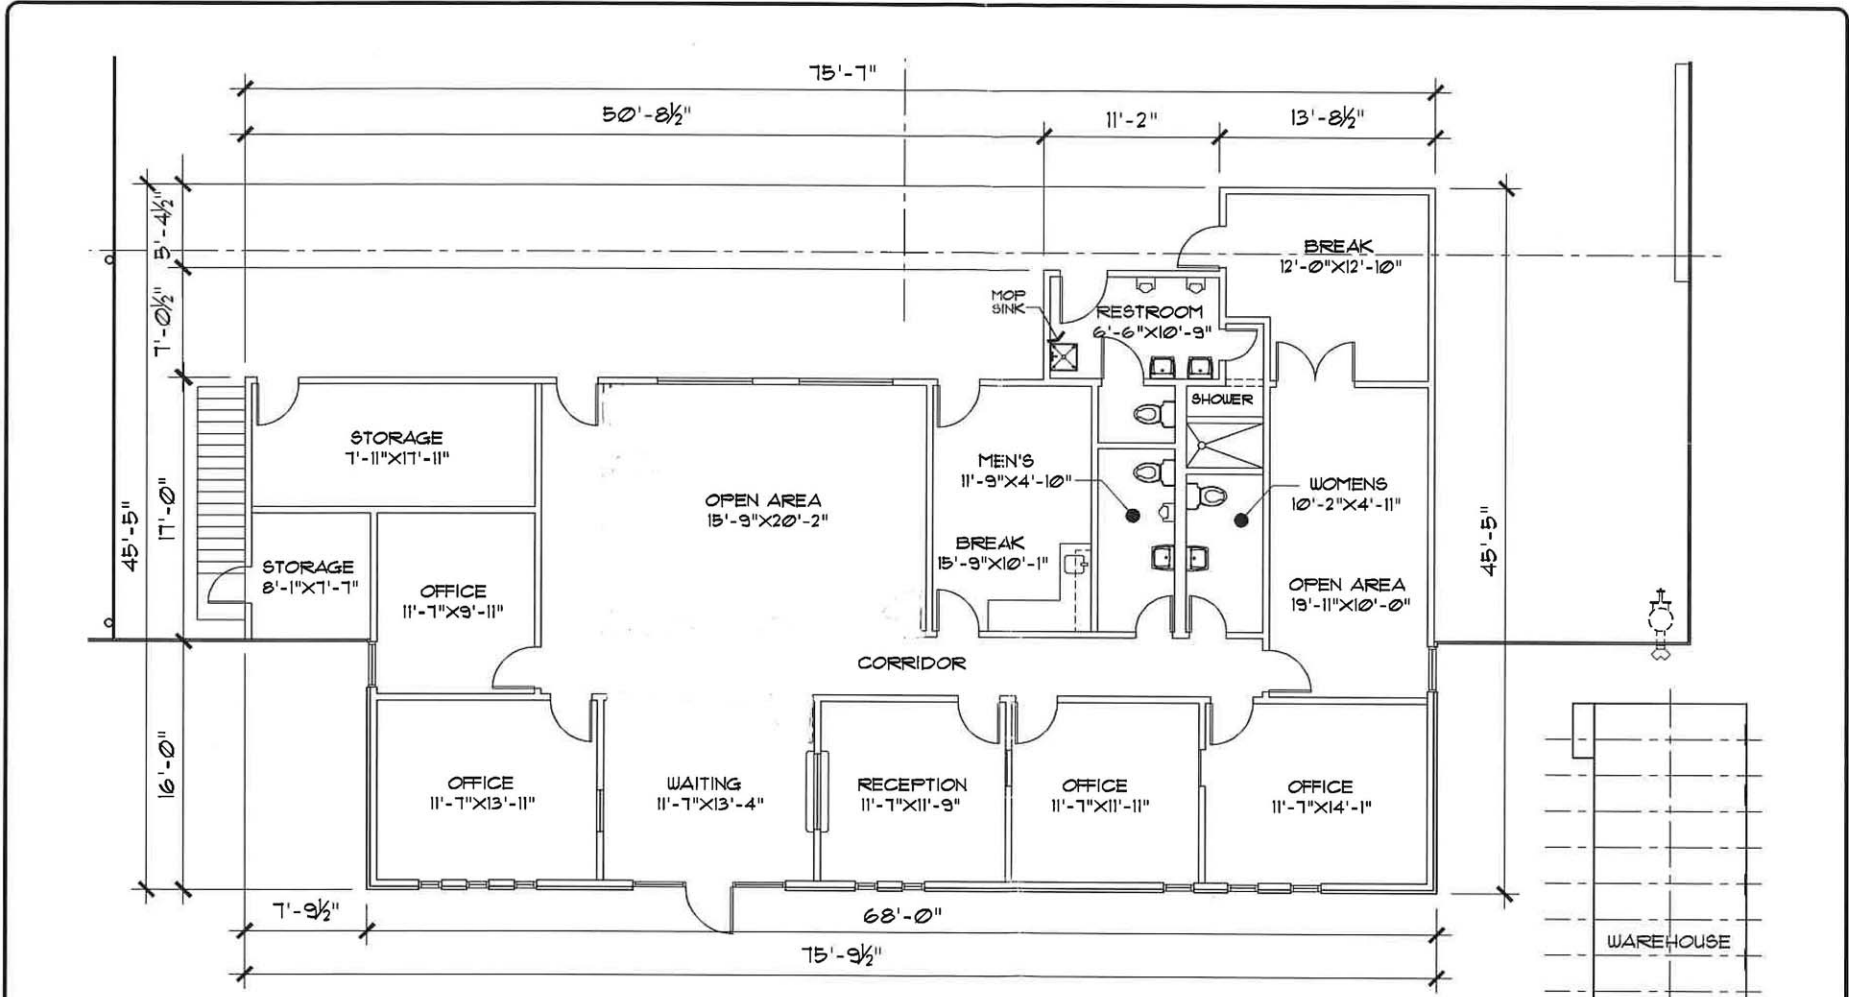

BUILDING TABULATIONS

OFFICE	2,593 SF.
WAREHOUSE	26,970 SF.
TOTAL:	29,563 SF.

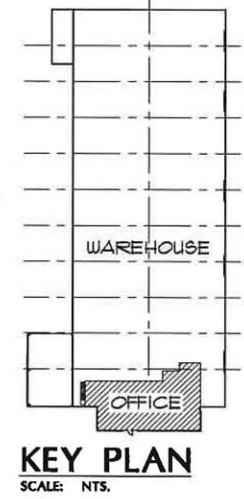

NOTE:
THIS CONCEPTUAL PLAN IS FOR MARKETING PURPOSES ONLY, AND HAS BEEN PREPARED FOR CLIENT BASED UPON PRELIMINARY AVAILABLE SITE INFORMATION DEEMED RELIABLE. ALL DIMENSIONS AND AREA CALCULATIONS ARE SUBJECT TO VERIFICATION AND MODIFICATION BY A PROFESSIONAL, FOR COMPLIANCE WITH ALL NATIONAL, STATE, AND LOCAL REGULATIONS. NOT FOR REGULATORY APPROVAL, PERMITTING, OR CONSTRUCTION.

AB1-120613

VILLA PARK
ARCHITECTURE/PLANNING/INTERIOR, PLLC
PH. (210) 384-8900
© 2013 ALL RIGHTS RESERVED

AS-BUILT FLOOR PLAN
3011 N. PAN-AM HWY
SAN ANTONIO, TEXAS 78219


DRAWN BY: _____
CHECKED BY: _____
DATE: 12/08/13
PROJECT: 1441 POPLAR
JOB NO: 13-298
SHEET

AB1

The information contained herein is furnished by sources deemed reliable, but is subject to verification by purchaser or tenant. 4M Realty Company assumes no responsibility and makes no guarantees, warranties or representations as to the completeness or accuracy thereof. The offering is made subject to errors, omissions, changes of price or condition, prior sale or lease, or withdrawal without notice.

4mrealty.com

FOR LEASE
3011 N. Pan Am (Interstate 35)

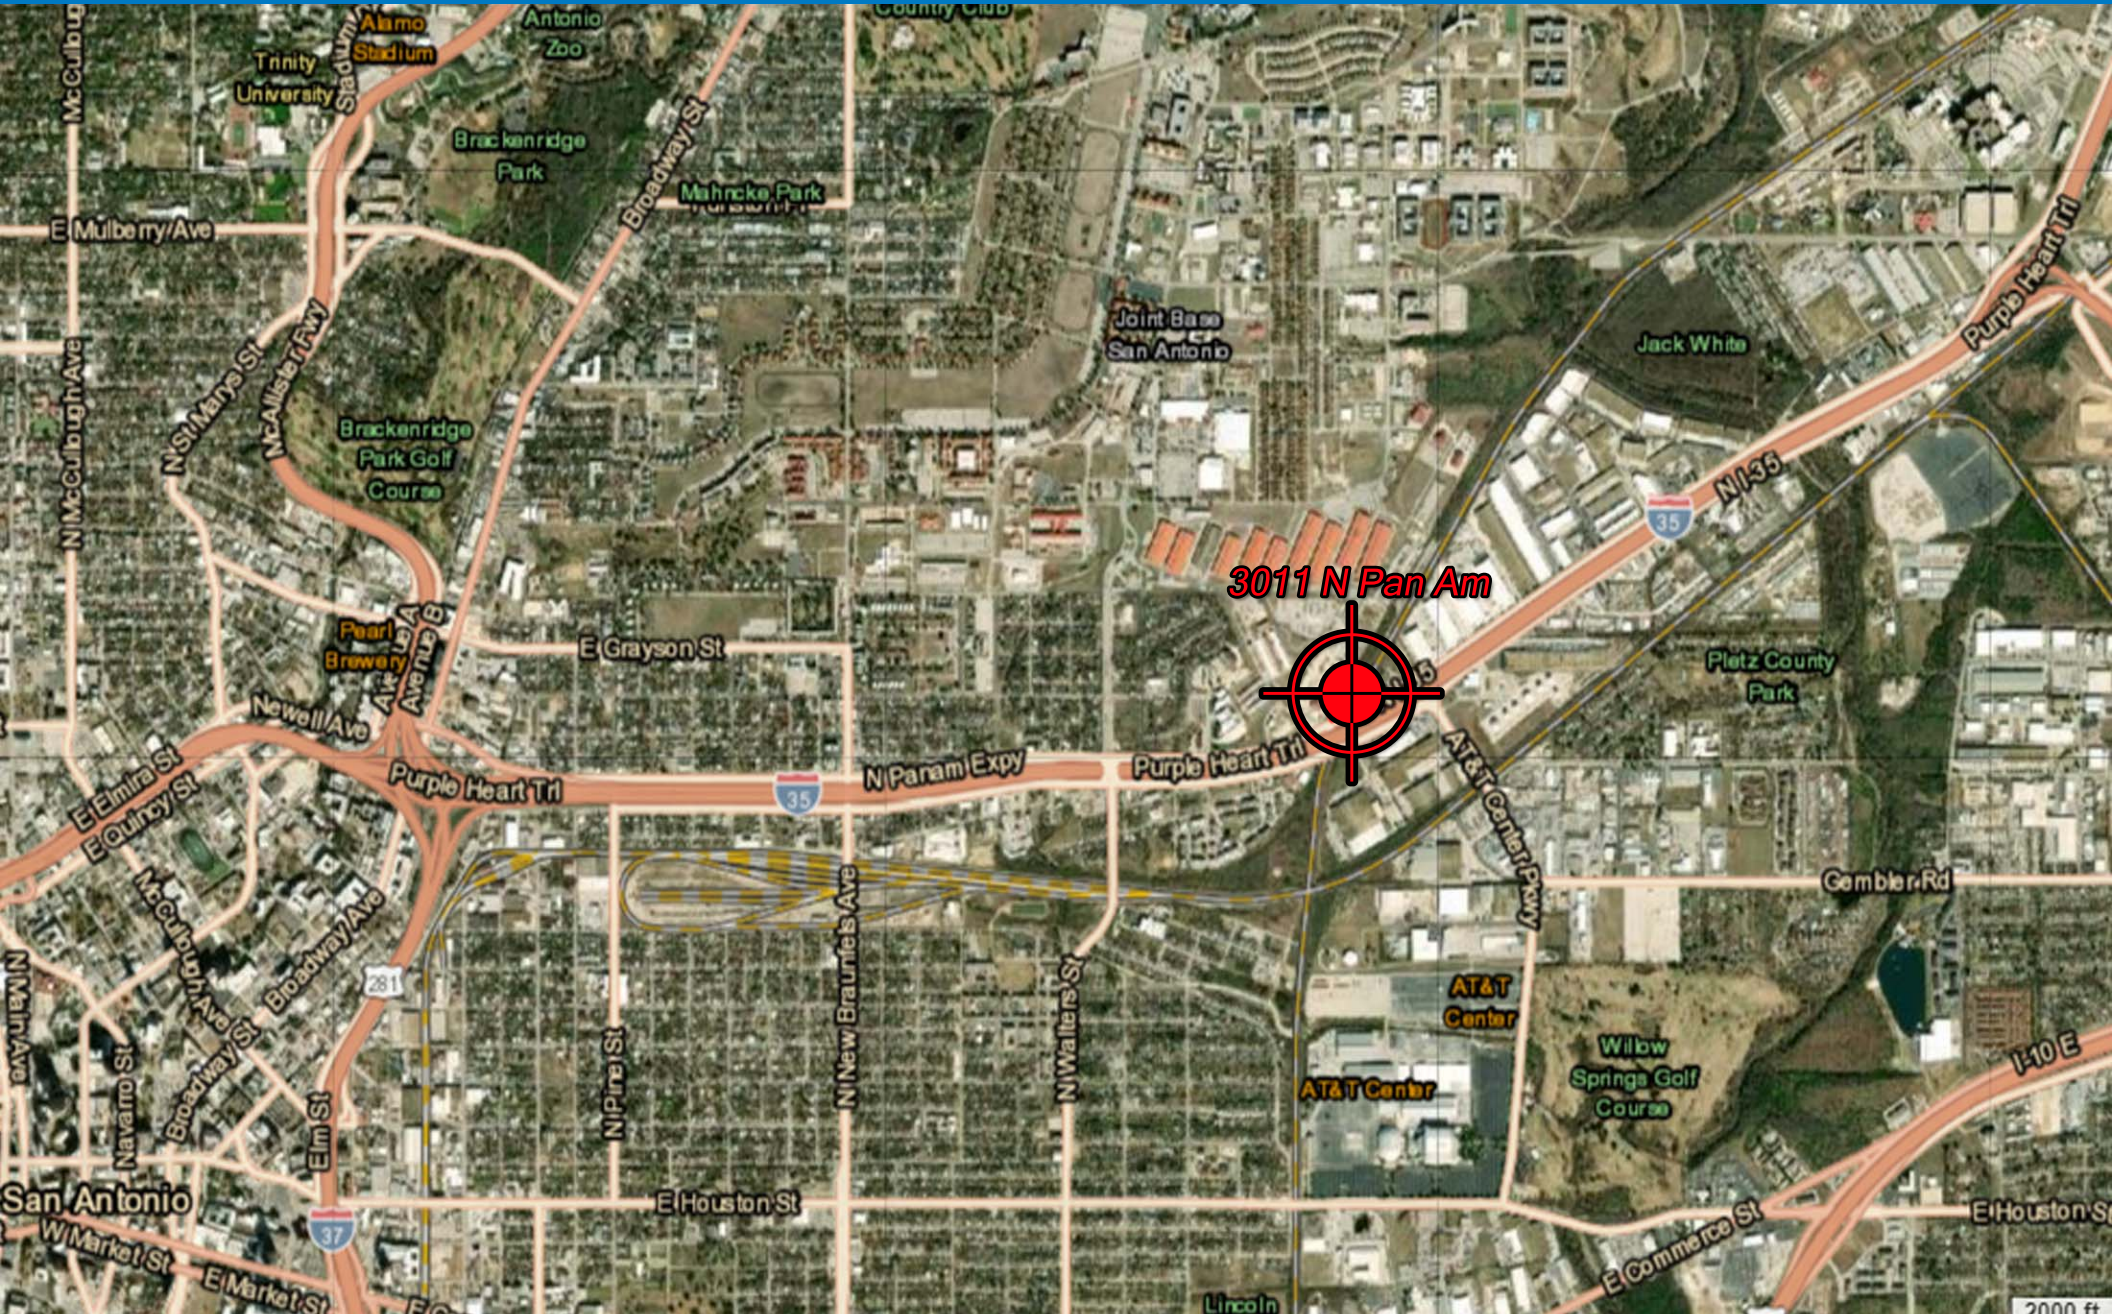


The information contained herein is furnished by sources deemed reliable, but is subject to verification by purchaser or tenant. 4M Realty Company assumes no responsibility and makes no guarantees, warranties or representations as to the completeness or accuracy thereof. The offering is made subject to errors, omissions, changes of price or condition, prior sale or lease, or withdrawal without notice.

4mrealty.com

FOR LEASE

3011 N. Pan Am (Interstate 35)

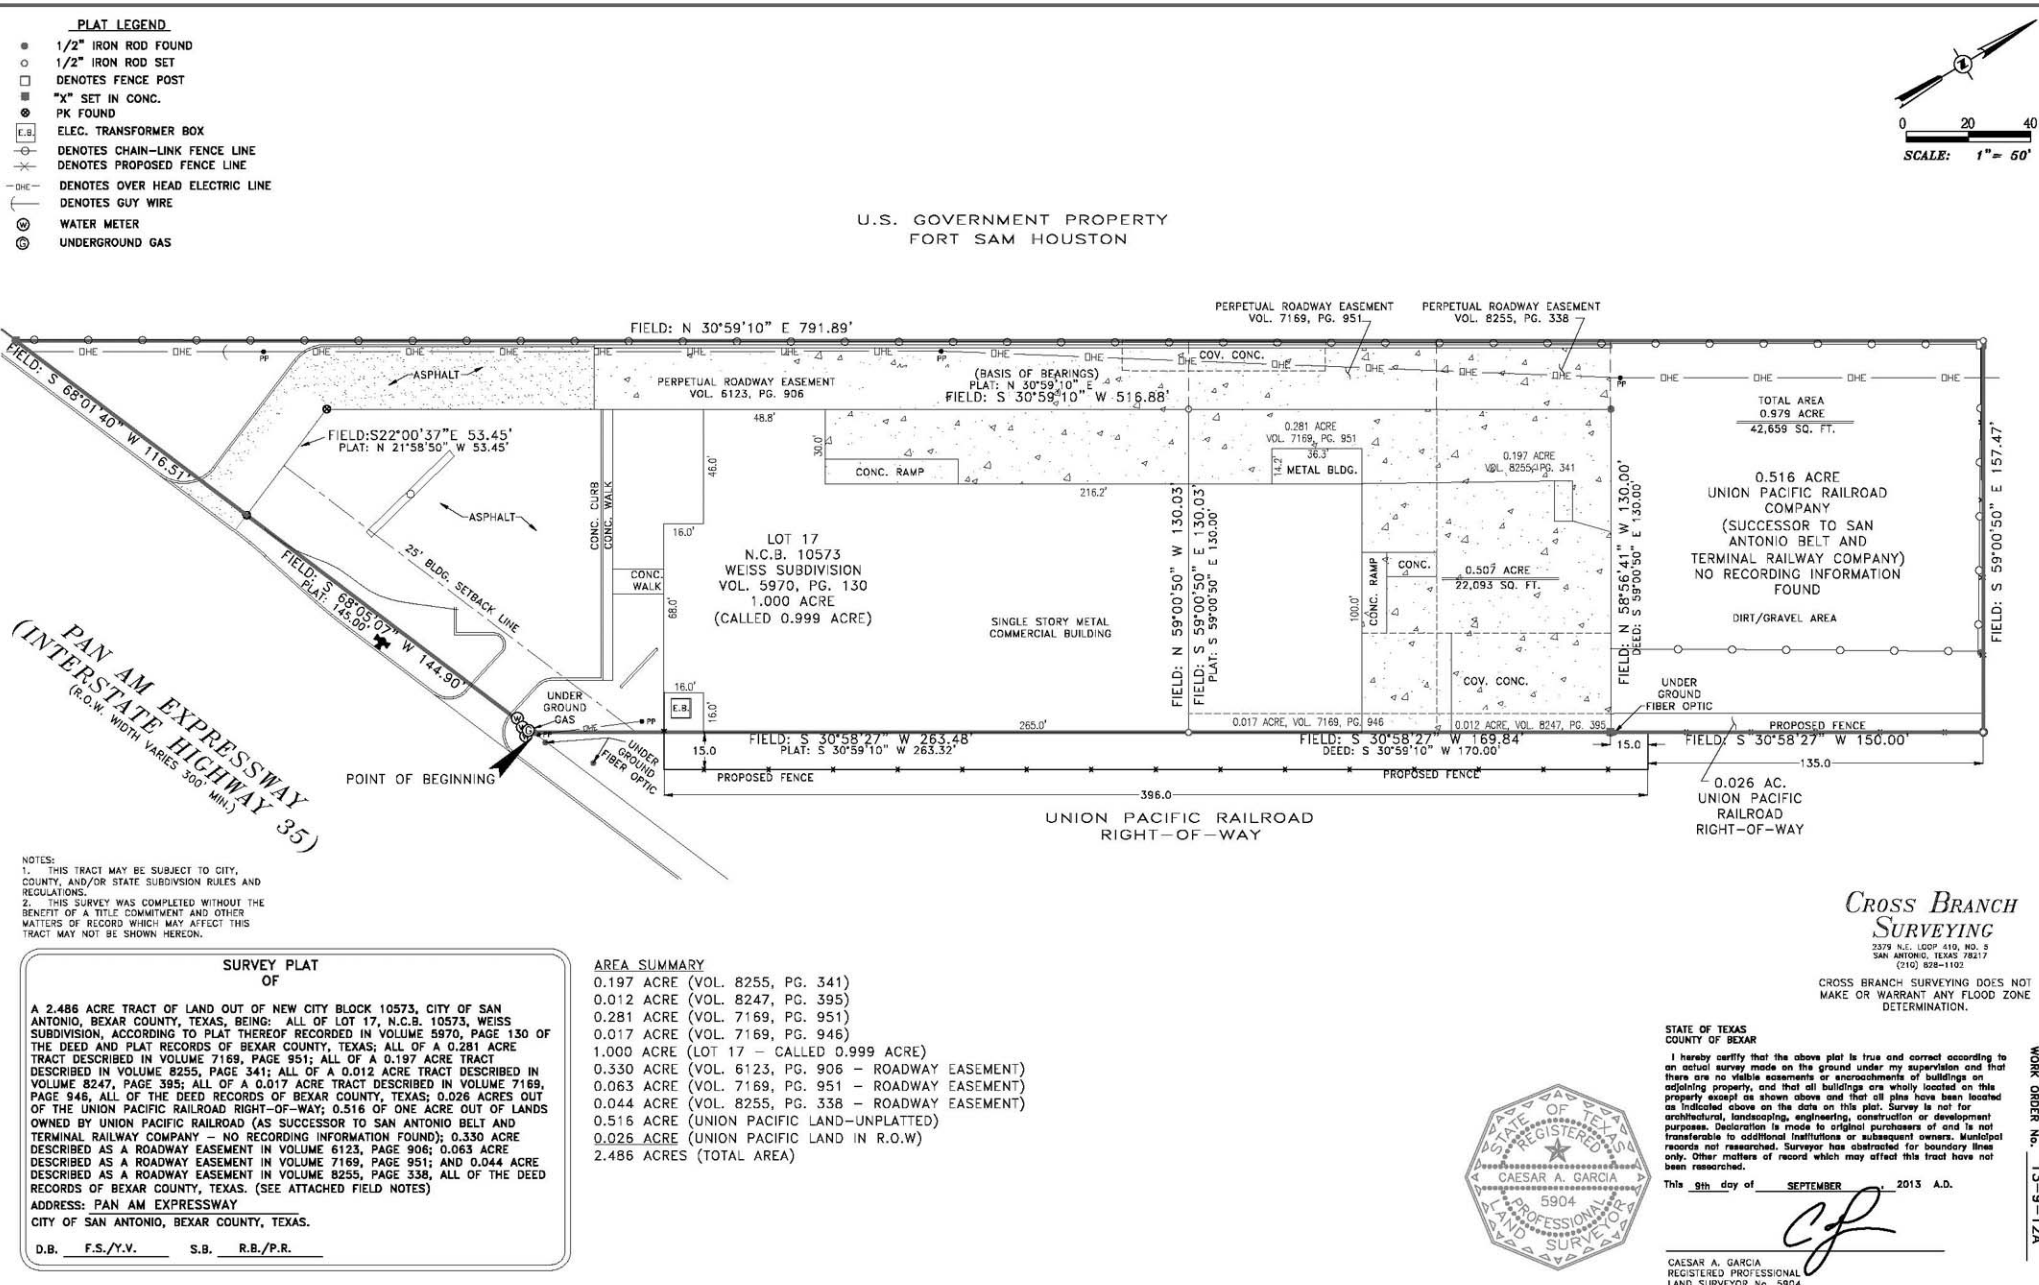

The information contained herein is furnished by sources deemed reliable, but is subject to verification by purchaser or tenant. 4M Realty Company assumes no responsibility and makes no guarantees, warranties or representations as to the completeness or accuracy thereof. The offering is made subject to errors, omissions, changes of price or condition, prior sale or lease, or withdrawal without notice.

4mrealty.com





Information About Brokerage Services

Before working with a real estate broker, you should know that the duties of a broker depend on whom the broker represents. If you are a prospective seller or landlord (owner) or a prospective buyer or tenant (buyer), you should know that the broker who lists the property for sale or lease is the owner's agent. A broker who acts as a subagent represents the owner in cooperation with the listing broker. A broker who acts as a buyer's agent represents the buyer. A broker may act as an intermediary between the parties if the parties consent in writing. A broker can assist you in locating a property, preparing a contract or lease, or obtaining financing without representing you. A broker is obligated by law to treat you honestly.

IF THE BROKER REPRESENTS THE OWNER:

The broker becomes the owner's agent by entering into an agreement with the owner, usually through a written - listing agreement, or by agreeing to act as a subagent by accepting an offer of subagency from the listing broker. A subagent may work in a different real estate office. A listing broker or subagent can assist the buyer but does not represent the buyer and must place the interests of the owner first. The buyer should not tell the owner's agent anything the buyer would not want the owner to know because an owner's agent must disclose to the owner any material information known to the agent.

IF THE BROKER REPRESENTS THE BUYER:

The broker becomes the buyer's agent by entering into an agreement to represent the buyer, usually through a written buyer representation agreement. A buyer's agent can assist the owner but does not represent the owner and must place the interests of the buyer first. The owner should not tell a buyer's agent anything the owner would not want the buyer to know because a buyer's agent must disclose to the buyer any material information known to the agent.

IF THE BROKER ACTS AS AN INTERMEDIARY:

A broker may act as an intermediary between the parties if the broker complies with The Texas Real Estate License Act. The broker must obtain the written consent of each party to the transaction to act as an

intermediary. The written consent must state who will pay the broker and, in conspicuous bold or underlined print, set forth the broker's obligations as an intermediary. The broker is required to treat each party honestly and fairly and to comply with The Texas Real Estate License Act. A broker who acts as an intermediary in a transaction:

- (1) shall treat all parties honestly;
- (2) may not disclose that the owner will accept a price less than the asking price unless authorized in writing to do so by the owner;
- (3) may not disclose that the buyer will pay a price greater than the price submitted in a written offer unless authorized in writing to do so by the buyer; and
- (4) may not disclose any confidential information or any information that a party specifically instructs the broker in writing not to disclose unless authorized in writing to disclose the information or required to do so by The Texas Real Estate License Act or a court order or if the information materially relates to the condition of the property.

With the parties' consent, a broker acting as an intermediary between the parties may appoint a person who is licensed under The Texas Real Estate License Act and associated with the broker to communicate with and carry out instructions of one party and another person who is licensed under that Act and associated with the broker to communicate with and carry out instructions of the other party.

If you choose to have a broker represent you, you should enter into a written agreement with the broker that clearly establishes the broker's obligations and your obligations. The agreement should state how and by whom the broker will be paid. You have the right to choose the type of representation, if any, you wish to receive. Your payment of a fee to a broker does not necessarily establish that the broker represents you. If you have any questions regarding the duties and responsibilities of the broker, you should resolve those questions before proceeding.

Real estate licensee asks that you acknowledge receipt of this information about brokerage services for the licensee's records.

3011 N. Pan Am
San Antonio, TX 78219

Buyer, Seller, Landlord or Tenant

Date